
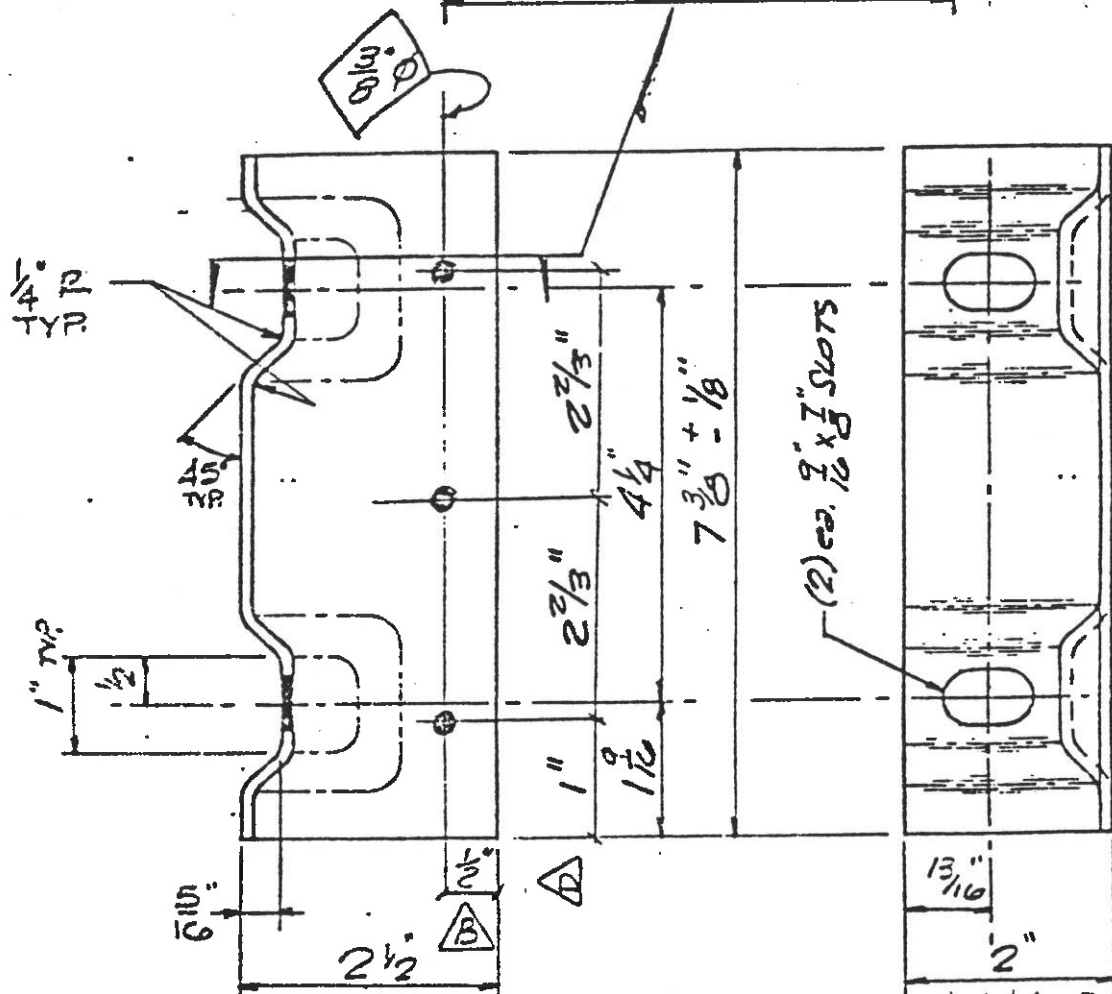


TO: SUPERSEDED BY EB 96-014 EFFECTIVE 4/8/96	<h1>ENGINEERING INSTRUCTION</h1> <p>NEW YORK STATE DEPARTMENT OF TRANSPORTATION</p>
Distribution: <input type="checkbox"/> Main Office <input type="checkbox"/> Regions <input checked="" type="checkbox"/> Special	SUBJECT: 7" BAND ANGLES FOR CORRUGATED STEEL PIPE Subject Code: Code: <u> EI - 84-18 </u> Date: <u> 3/23/84 </u> Supersedes:
APPROVED: <i>James J. Murphy</i> <hr/> James J. Murphy, Director, Materials Bureau	

The attached drawings have been approved and added to the NYSDOT Approved List as Materials Details. This approval will allow the 7 inch band angles depicted, as alternates to the 2" X 2" X 3/16" standard 7 inch long hot rolled galvanized steel angle for banding corrugated steel pipe 30 inches and less in diameter provided the product arriving at a project site is accompanied with a copy of either of the attached drawings as required by Engineering Instruction 83-3, Materials Method - NY 25. The specifications have been revised to allow these band angles on future contracts. The Construction Division will issue separate instructions for ongoing contracts.

PRELIMINARY PLAN REVIEW
 BUREAU
 APR 12 1984
 ROOM 408 BLDG. 5

PREL.	FINAL
DESIGN	LANDSCAPE
RECEIVED FACILITIES DESIGN DIVISION APR 2 1984	
CIRC.	FILE

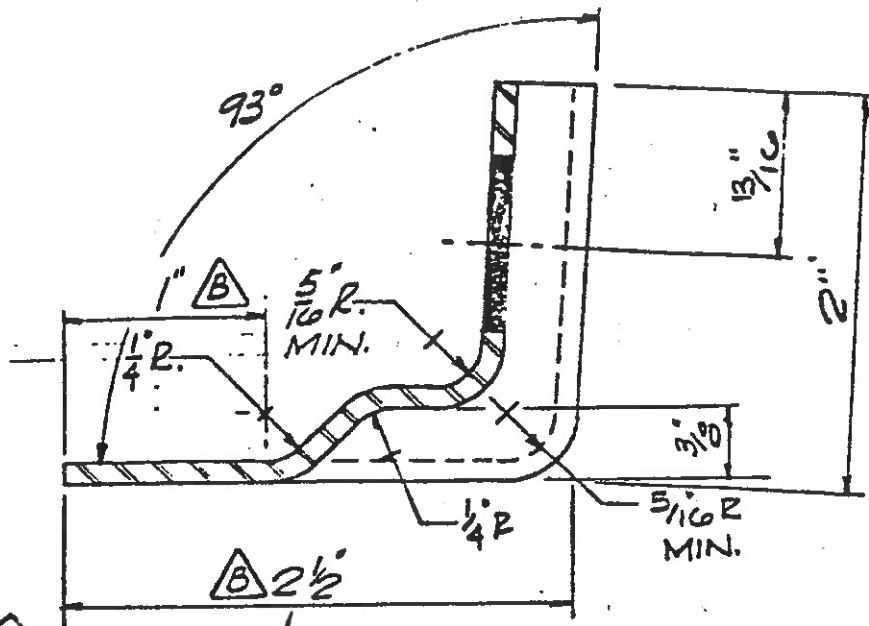

MATERIAL: AASHTO M218-82 AND ASTM A444-82 \triangle \triangle
 Material: 12 Ga. Galv. (.100) min. Wt.: 1.0# Shear Size: 4 1/4 x 7 1/2



\triangle	F	5/24/78	4 1/4 WAS 4 1/2, 2 1/2 WAS 2 1/4, 1 WAS 3/4 & REDDRAWN
REV	BY	DATE	DESCRIPTION OF CHANGE

SCAFCO CORPORATION
 SPOKANE, WA

ALL DIMENSIONS IN INCHES — TOLERANCES — LINEAR — 1/16", ANGULAR — 1°

7" BAND ANGLE

DRAWN BY FETV	DATE 5-20-78	DRAWING NO. 100101
APPROVED	SCALE NONE	

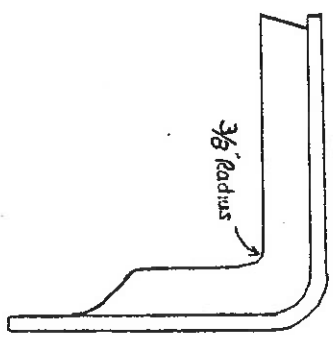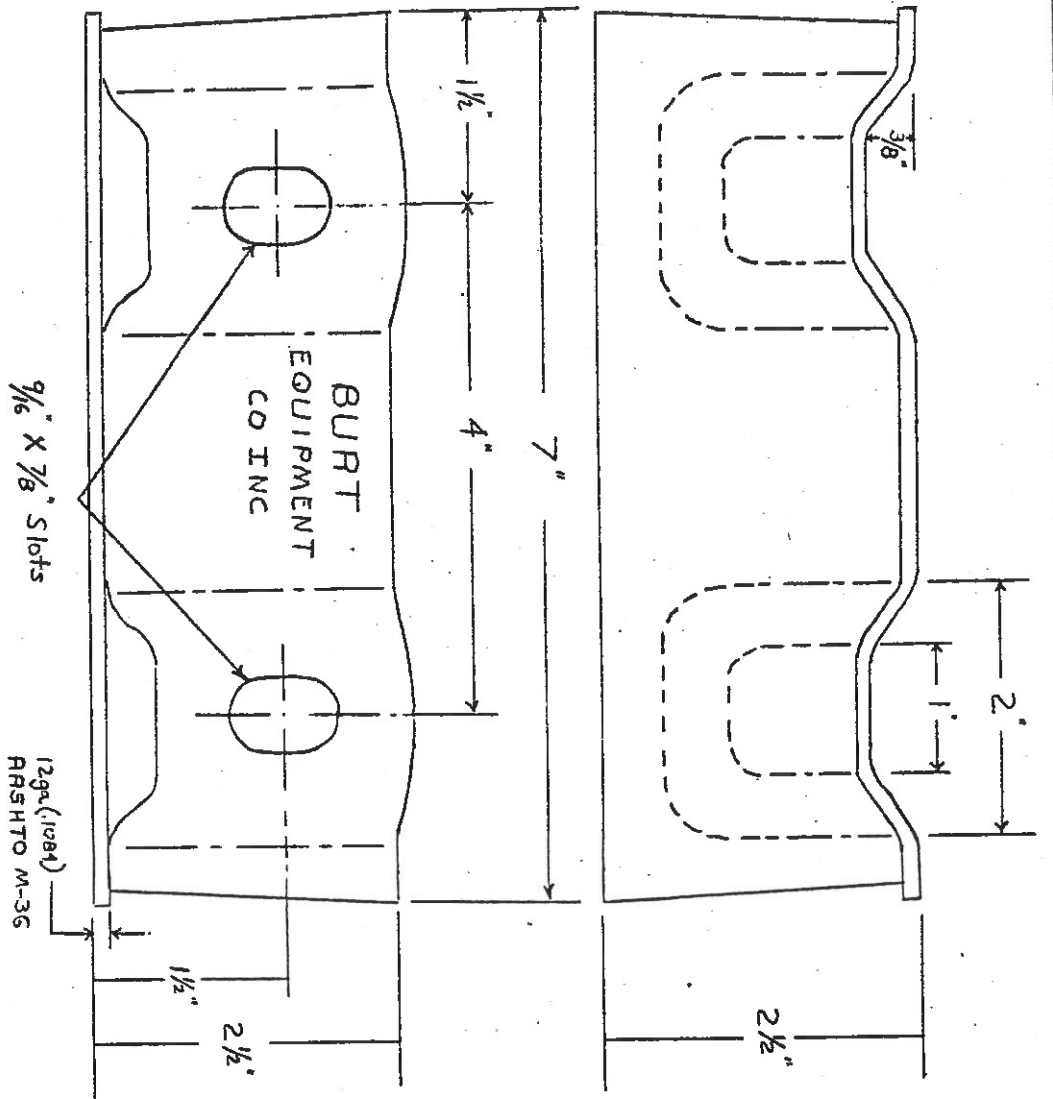

TOLERANCES (unless as noted)		REVISIONS			DRAWN BY		SCALE		MATERIAL	
DECIMAL	FRACTIONAL	NO	DATE	BY	CHK'D	DATE	FULL	12 G. & Galv	DRAWING NO	
±	±	1			WSB	2/10/94	FULL		BA-7	
±	±	2								
±	±	3								
±	±	4								
±	±	5								

BURT EQUIPMENT CO INC
WESTMINSTER STA VERMONT

BAND ANGLE 7"

12 G. & Galv
DRAWING NO
BA-7